



11333 N. Cedarburg Road  
Mequon, WI 53092  
Phone: 262-236-2918  
Fax: 262-242-9655

[www.ci.mequon.wi.us](http://www.ci.mequon.wi.us)

Office of Parks and Operations

**PARK AND OPEN SPACE BOARD**  
**Wednesday, October 16, 2024**  
**6:30 PM**  
**South Conference Room**

**Agenda**

- a) Call to Order, Roll Call
- b) Discussion Items
  - a. Master Plan Review and Feedback
  - b. Rotary Park/ Spirit Lake Boardwalk
  - c. Lemke Update
- c) Adjourn

*Dated: October 16, 2024*


*/s/ Jason Cain, Chair*

.....  
Notice is hereby given that a quorum of other governmental bodies may be present at this meeting to present, discuss and/or gather information about a subject over which they have decision-making responsibility, although they will not take formal action thereto at this meeting.

Persons with disabilities requiring accommodations for attendance at this meeting should contact the City Clerk's Office at 262-236-2914, twenty-four (24) hours in advance of the meeting.

Any questions regarding this agenda may be directed to the Parks Department Office at 262-236-2945 Monday through Friday 8:00 am – 4:30 pm.

To W BONNIWELL RD ↑

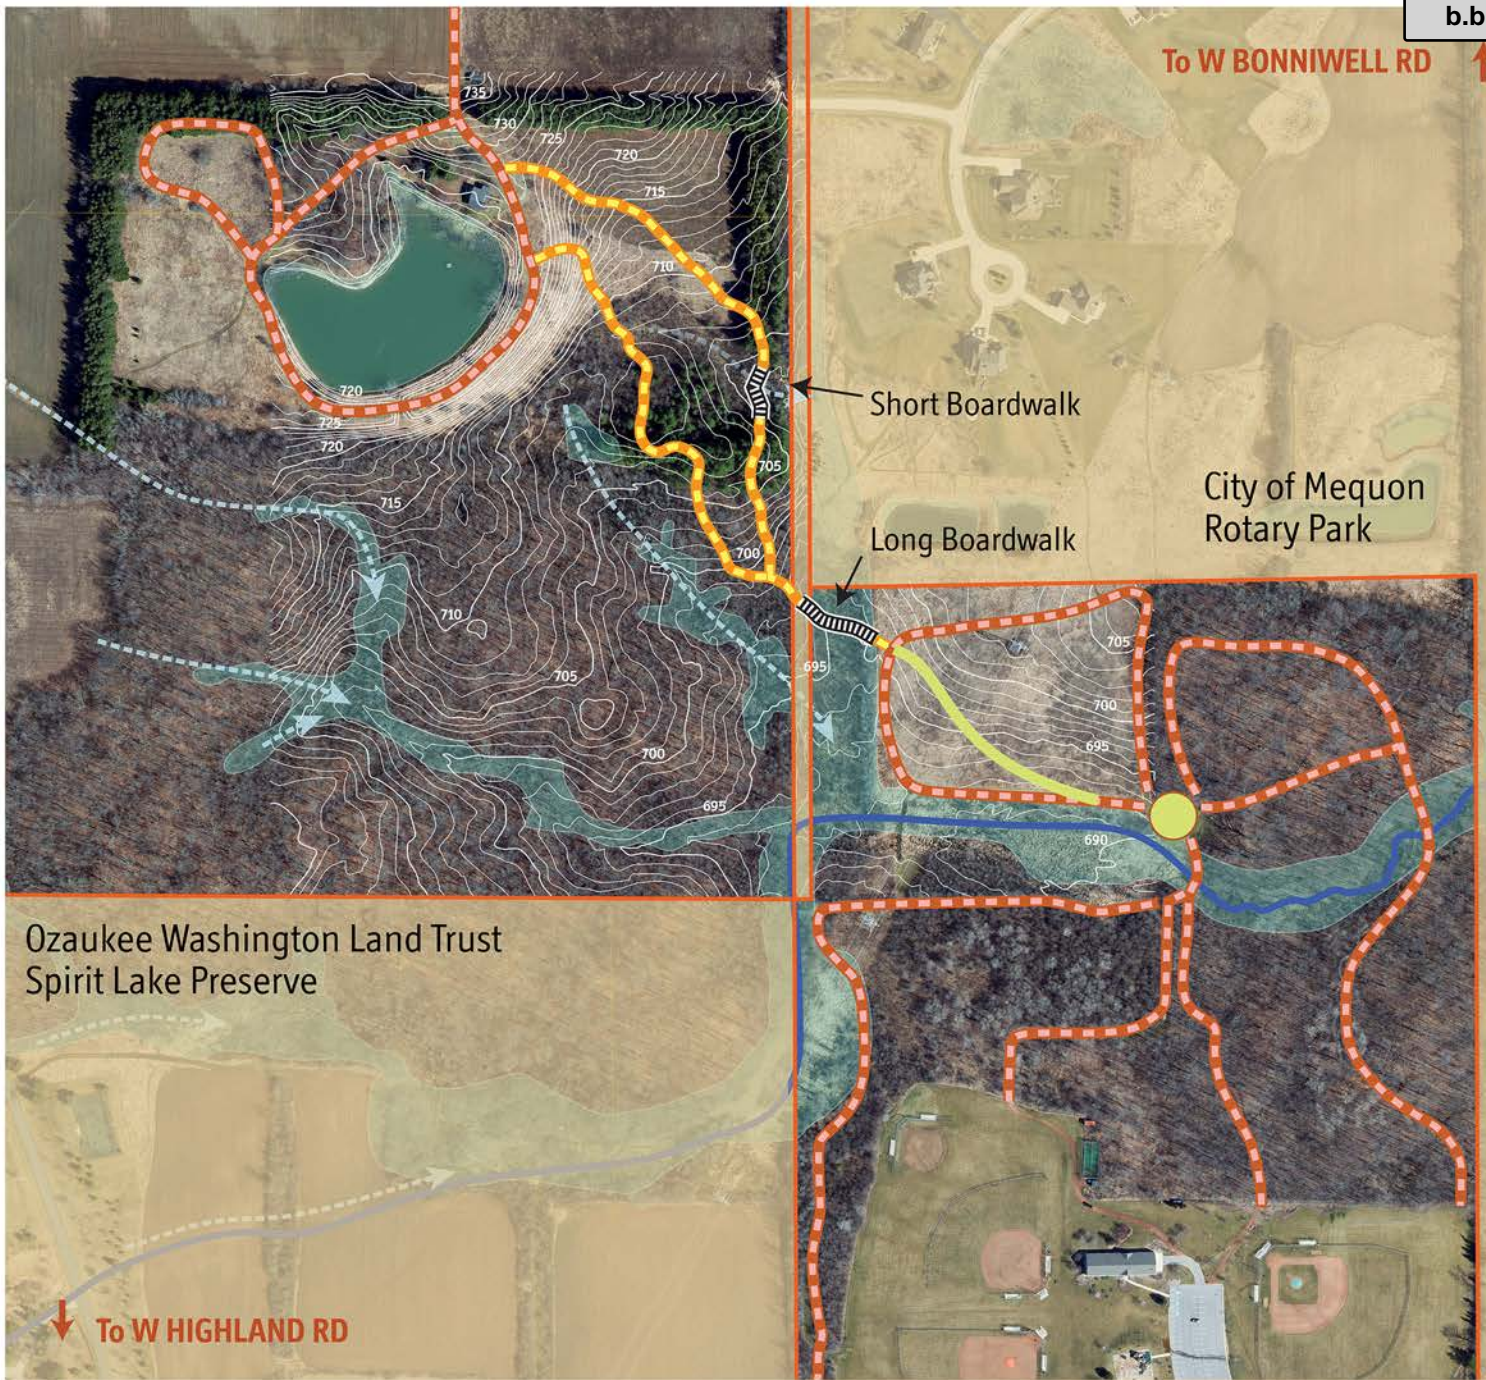

Short Boardwalk

Long Boardwalk

City of Mequon Rotary Park

Ozaukee Washington Land Trust Spirit Lake Preserve

To W HIGHLAND RD ↓

### Proposed Connector Trail, Pukaite Woods/Rotary Park and Spirit Lake Preserve



To W BONNIWELL RD ↑

City of Mequon Rotary Park

Ozaukee Washington Land Trust Spirit Lake Preserve

To W HIGHLAND RD ↓

### Proposed Connector Trail, Pukaite Woods/Rotary Park and Spirit Lake Preserve



New Spirit Lake Trail Loop



Existing Trails Spirit Lake Preserve and Mequon Rotary Park / Pukaite Woods



Mapped Wetlands



Proposed Long Curving Boardwalk



Proposed Near-Term Invasive Species Work:  
1 = buckthorn focus  
2 = multiflora rose focus  
3 = trail corridor widening  
4 = trail corridor widening




Perennial Surface Flow



Proposed Short Boardwalk



Ephemeral Flow Paths

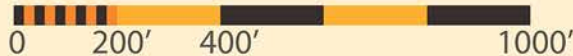

# Long Curving Boardwalk (Rotary Park)


Total length: 172'  
 Height < 16" throughout. Total grade change ~24" (lowest in center).  
 Comprised of 21 sections each 5' wide x8' long  
 Curve 1 managed with four curve extender sections, 22 degrees.  
 Curve 2 managed with six or seven curve extender sections, 35 degrees.  
 Curve 3 managed with two curve extender sections, 7 degrees.  
 Decking: 5/4 x 6"  
 Include end ramps to grade  
 Include wheel stops along side edges of entire boardwalk

Nearby mapped wetlands shown shaded.  
 Elevations are 1' contours.  
 Property boundaries shown.




(If this map is printed unscaled at 8.5x11 in, scale is 1"=30')

Landscapes of Place 02 October 2024

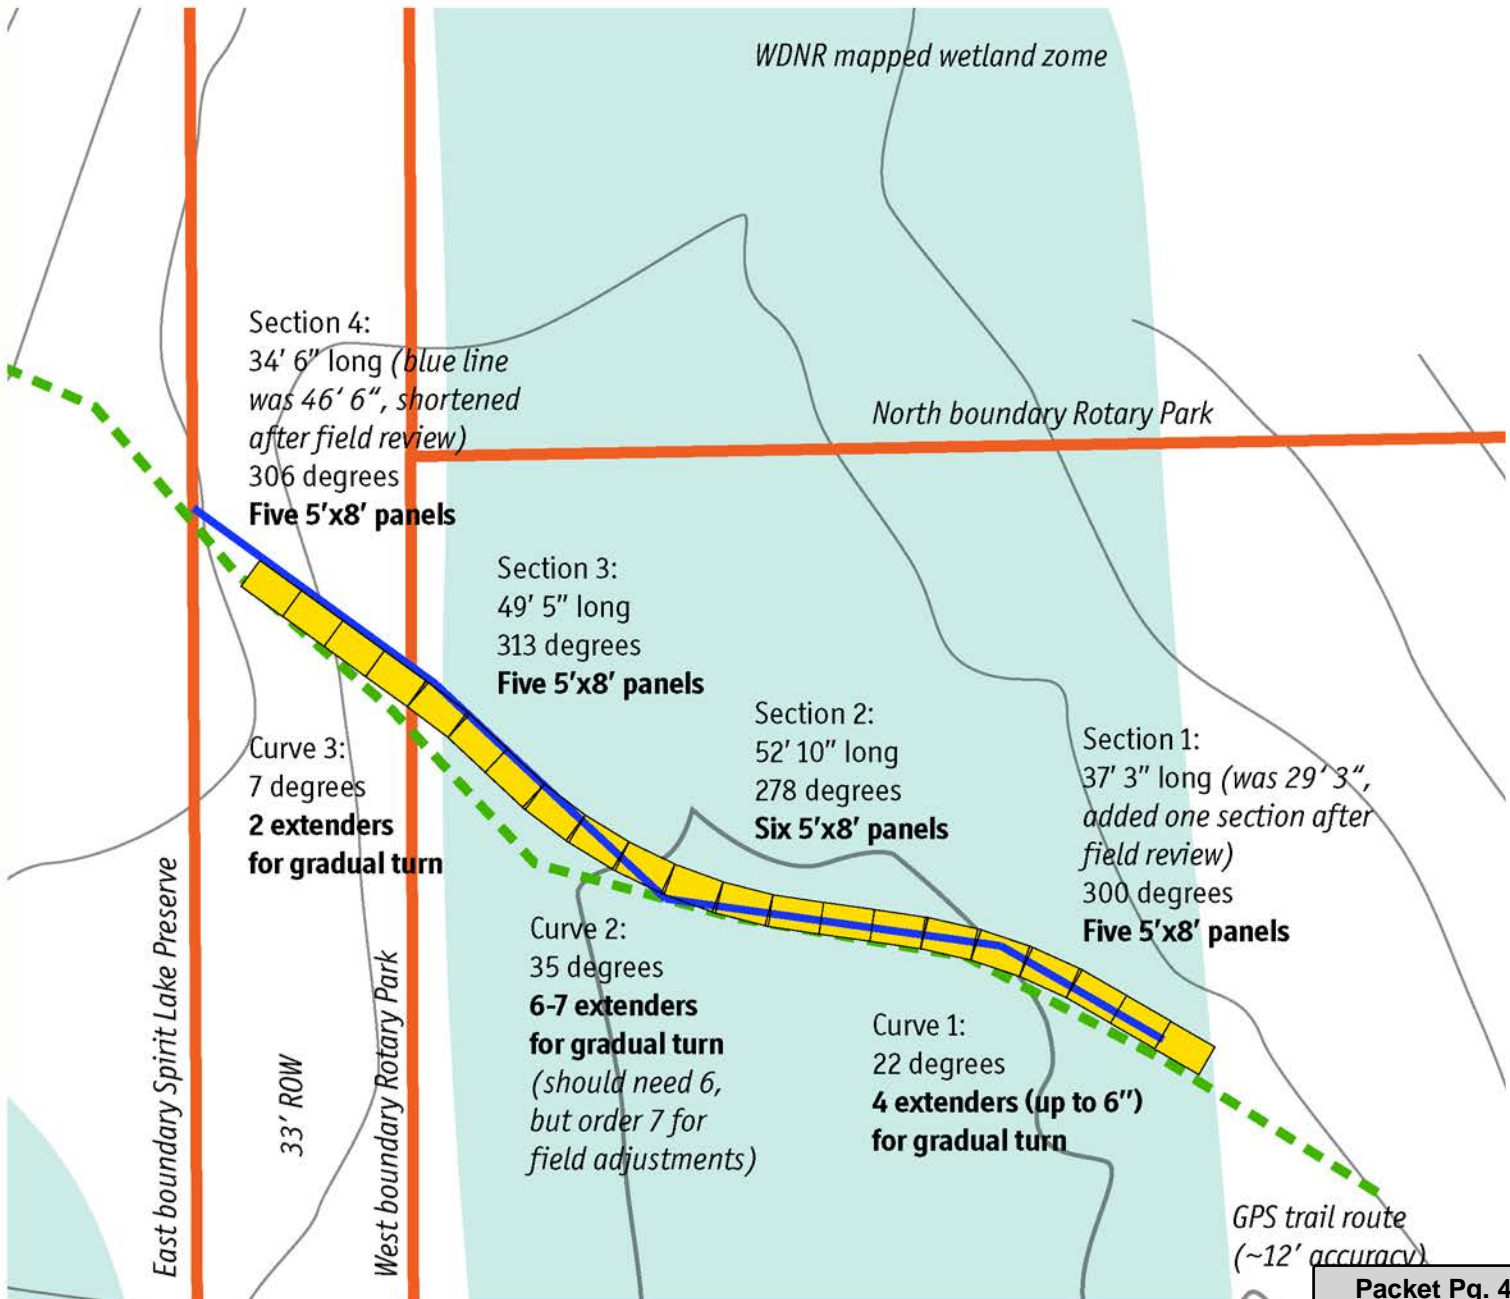

Attachment: Spirit Lake - Rotary Park - LoP (9765 : Rotary Park/ Spirit Lake Boardwalk)

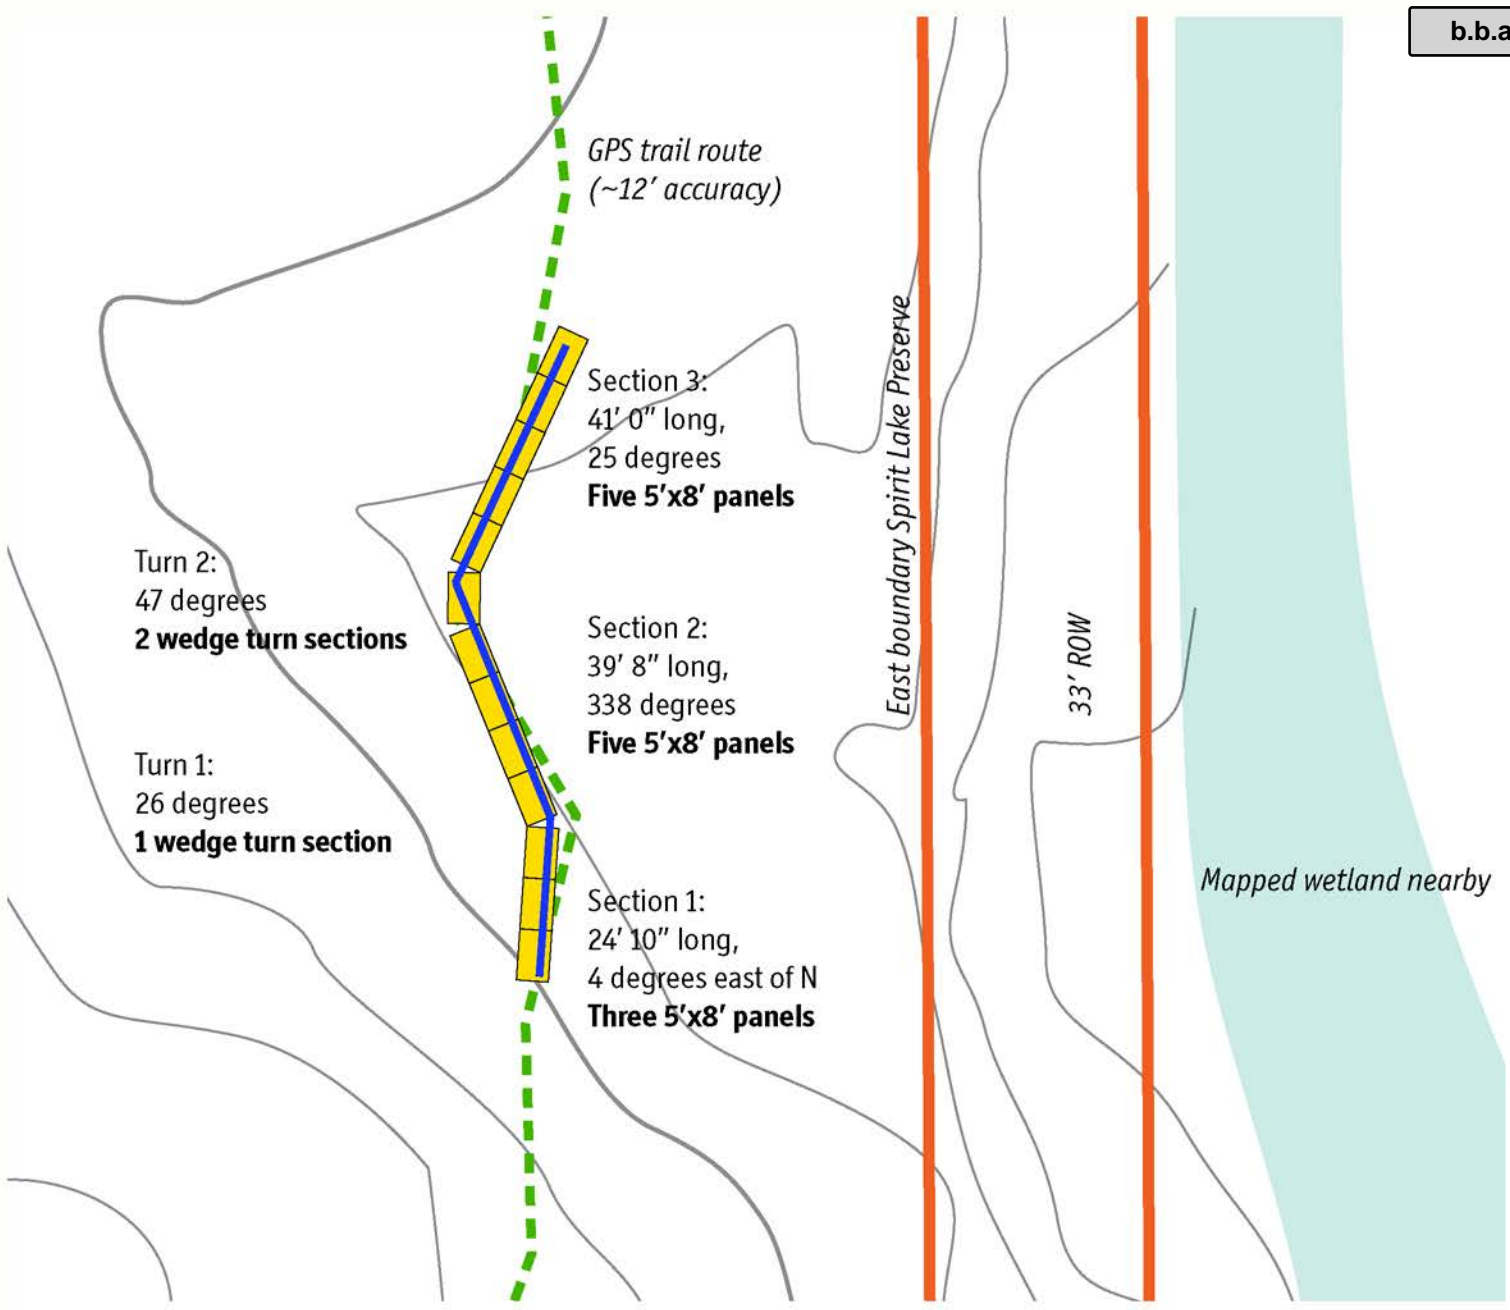

### Short Boardwalk (Spirit Lake Preserve)

- Total length: 105'
- Height < 16" throughout. Total grade change ~18" (lowest in center).
- Comprised of 13 sections each 5' wide x8' long
- Turn 1 managed with one wedge "turn" section, 26 degrees.
- Turn 2 managed with two wedge "turn" sections, each 23.5 degrees.
- Decking: 5/4 x 6"
- Include end ramps to grade
- Include wheel stops along side edges of entire boardwalk

Nearby mapped wetlands shown shaded.  
Elevations are 1' contours.  
Property boundaries shown.



(If this map is printed unscaled at 8.5x11 in, scale is 1"=30')

Landscapes of Place 02 October 2024

Attachment: Spirit Lake - Rotary Park - LoP (9765 : Rotary Park/ Spirit Lake Boardwalk)

Rotary Park / Spirit Lake Trail GPS track

Waypoints															
Date	Name	Latitude	Longitude	Altitude (m)	Notes										
2024-09-29 20:41:06.37		43.225882	-87.984277	202.0823											
2024-09-29 20:53:02.99	Parking Corner	43.255821	-87.961233	216.8116											
2024-09-29 20:54:21.09	Edge of Woods	43.256277	-87.960551	218.4157											
2024-09-29 20:57:16.89	Center of Bridge	43.257913	-87.961032	213.6383											
2024-09-29 21:00:18.62	Junction	43.258483	-87.963159	212.3584											
2024-09-29 21:01:46.84	Junction at Curve	43.259220	-87.963272	213.7973											
2024-09-29 21:02:59.53	Start of Long Boardwalk	43.259293	-87.963445	213.8834											
2024-09-29 21:06:37.17	End of 1 Segment 29 Ft	43.259331	-87.963529	214.2195											
2024-09-29 21:07:45.10	End of 2 Segment 52	43.259343	-87.963702	214.6281											
2024-09-29 21:09:53.29	End of 3 Segment 49	43.259433	-87.963846	214.7001											
2024-09-29 21:13:00.17	End of 4 Segment 46	43.259528	-87.963971	214.1760											
2024-09-29 21:14:11.55	Trail Junction	43.259596	-87.964135	215.1107											
2024-09-29 21:19:13.32	Center of Pines	43.260270	-87.964202	218.0553											
2024-09-29 21:21:26.70	Start of Little Boardwalk	43.260458	-87.964171	218.7936											
2024-09-29 21:22:43.33	End of 1 Segment 24	43.260482	-87.964201	217.9914											
2024-09-29 21:25:15.13	End of 2 Segment 39	43.260600	-87.964245	217.0483											
2024-09-29 21:27:15.61	End of Little Boardwalk 41	43.260706	-87.964197	217.0323											
2024-09-29 21:29:45.02	Edge of Woods	43.261035	-87.964380	216.9052											
2024-09-29 21:32:19.54	Top of Trail in line w Maples	43.261759	-87.965907	222.0614											
Track															
Date(GMT)	Date(Local)	Time(sec)	Latitude	Longitude	Horizontal Accuracy(m)	Altitude(m)	Vertical Accuracy(m)	Distance(m)	Speed(m/s)	Average Speed(m/s)	Course(deg)	True Heading(deg)	Magnetic Heading(deg)	Heading Accuracy(deg)	Glide Ratio
2024-09-29 20:52:42.00	2024-09-29 15:52:42.00	0	43.255824	-87.961243	4.6019	216.9532	3.5562	0.0000	1.2300	0.8904	273.5156	60.5760	64.6448	11.0988	-71.3814
2024-09-29 20:52:43.00	2024-09-29 15:52:43.00	0	43.255823	-87.961235	4.6019	216.8471	3.5562	0.0000	0.0000	0.8904	-1.0000	59.3600	63.4288	11.0982	-96.1145
2024-09-29 20:53:15.00	2024-09-29 15:53:15.00	32.0093	43.255815	-87.961106	4.7404	218.1186	3.3694	10.5688	0.1355	1.0779	243.9707	89.3691	93.4379	11.0137	-41.6256
2024-09-29 20:53:23.00	2024-09-29 15:53:23.00	40.0084	43.255821	-87.960974	4.7395	217.8821	3.3707	21.2799	0.1186	1.3525	243.9707	88.2668	92.3356	11.0121	-32.8070
2024-09-29 20:53:31.00	2024-09-29 15:53:31.00	48.0129	43.255881	-87.960880	4.7397	217.9967	3.3705	31.4033	0.1630	1.3101	243.9708	37.0096	41.0784	11.0114	-141.7677
2024-09-29 20:53:39.00	2024-09-29 15:53:39.00	56.0090	43.255965	-87.960810	4.7401	218.3388	3.3698	42.2563	0.1127	1.4022	243.9709	47.7791	51.8479	11.0086	45.2312
2024-09-29 20:53:46.00	2024-09-29 15:53:46.00	63.0091	43.256041	-87.960738	4.7383	218.8293	3.3724	52.5634	0.1252	1.4256	243.9709	44.6511	48.7199	11.0075	29.6214
2024-09-29 20:53:53.99	2024-09-29 15:53:53.99	71.0105	43.256115	-87.960661	4.7444	219.0280	3.3638	62.8661	0.1180	1.3669	243.9710	50.1112	54.1800	11.0118	28.9998
2024-09-29 20:54:01.99	2024-09-29 15:54:01.99	79.0090	43.256192	-87.960594	4.7462	219.0642	3.3613	73.0628	0.1113	1.2138	243.9710	45.4912	49.5600	11.0136	249.2165
2024-09-29 20:54:10.99	2024-09-29 15:54:10.99	88.0089	43.256277	-87.960551	4.7433	218.4157	3.3653	83.0935	0.1275	0.7826	243.9711	24.3002	28.3690	11.0261	-27.3319
2024-09-29 20:54:33.99	2024-09-29 15:54:33.99	111.0087	43.256368	-87.960571	4.7471	218.6641	3.3600	93.3304	0.1495	0.8210	243.9711	334.5718	338.6406	11.0384	8.7767
2024-09-29 20:54:42.99	2024-09-29 15:54:42.99	120.0086	43.256445	-87.960641	4.7452	218.6212	3.3627	103.6018	0.8056	1.0703	331.8021	347.5618	351.6306	11.0265	13.3449
2024-09-29 20:54:50.99	2024-09-29 15:54:50.99	128.0087	43.256539	-87.960654	4.7511	218.6967	3.3544	114.1699	1.0507	1.4349	355.7194	334.7863	338.8551	11.0267	168.4681
2024-09-29 20:54:59.99	2024-09-29 15:54:59.99	137.0080	43.256631	-87.960690	4.7417	217.6980	3.3676	124.7328	0.9555	1.0889	333.6929	316.7935	320.8623	11.0437	-31.6141
2024-09-29 20:55:07.99	2024-09-29 15:55:07.99	145.0088	43.256736	-87.960699	4.7522	217.4491	3.3528	136.4530	1.2908	1.3602	355.8643	350.0635	354.1323	11.0555	-21.3864
2024-09-29 20:55:16.99	2024-09-29 15:55:16.99	154.0086	43.256827	-87.960728	4.7484	217.7885	3.3582	146.7949	1.1537	0.8559	343.3311	324.6226	328.6914	11.0457	244.6522
2024-09-29 20:55:25.99	2024-09-29 15:55:25.99	163.0088	43.256900	-87.960820	4.7486	216.5126	3.3578	157.8291	1.1177	1.3990	308.1016	316.6077	320.6765	11.0352	-17.9519

Attachment: Spirit Lake - Rotary Park - LoP (9765 : Rotary Park/ Spirit Lake Boardwalk)

2024-09-29 20:55:32.99	2024-09-29 15:55:32.99	170.0099	43.256973	-87.960893	4.7446	216.7422	3.3636	167.9719	1.0881	1.5189	326.9562	330.0446	334.1134	11.0434	-22.9619
2024-09-29 20:55:40.99	2024-09-29 15:55:40.99	178.0115	43.257062	-87.960933	4.7607	216.5881	3.3407	178.2930	1.1347	1.1357	349.6704	354.0568	358.1256	11.0344	173.6205
2024-09-29 20:55:48.99	2024-09-29 15:55:48.99	186.0084	43.257152	-87.960891	4.7455	215.5835	3.3622	188.8658	1.1097	1.5714	29.1878	19.1834	23.2522	11.0490	-23.9098
2024-09-29 20:55:57.99	2024-09-29 15:55:57.99	195.0086	43.257246	-87.960891	4.7524	215.0035	3.3525	199.3080	0.9006	1.4247	327.7829	325.2555	329.3243	11.0500	-11.0466
2024-09-29 20:56:05.99	2024-09-29 15:56:05.99	203.0086	43.257303	-87.960996	4.7422	214.8635	3.3669	209.9969	0.9467	1.3463	296.8999	283.6562	287.7250	11.0474	-21.9205
2024-09-29 20:56:14.99	2024-09-29 15:56:14.99	212.0087	43.257366	-87.961098	4.7433	215.2750	3.3653	220.7783	1.2122	1.2394	328.6226	349.2267	353.2955	11.0413	822.4696
2024-09-29 20:56:23.99	2024-09-29 15:56:23.99	221.0093	43.257459	-87.961121	4.7418	213.9171	3.3675	231.2893	0.9382	1.1368	355.1463	11.9946	16.0634	11.0535	-27.7296
2024-09-29 20:56:31.99	2024-09-29 15:56:31.99	229.0126	43.257552	-87.961105	4.7502	214.2911	3.3556	241.7654	1.1752	1.2960	3.8785	16.1460	20.2148	11.0497	-49.2796
2024-09-29 20:56:39.99	2024-09-29 15:56:39.99	237.0087	43.257649	-87.961075	4.7467	213.6705	3.3605	252.7998	1.0269	1.4983	18.4936	20.6738	24.7426	11.0562	208.5827
2024-09-29 20:56:48.99	2024-09-29 15:56:48.99	246.0089	43.257748	-87.961049	4.7465	213.8198	3.3609	264.0345	1.2630	1.2945	6.7157	15.2587	19.3275	11.0558	-127.9006
2024-09-29 20:56:56.99	2024-09-29 15:56:56.99	254.0092	43.257842	-87.961038	4.7473	213.3682	3.3597	274.4103	1.2813	1.0730	5.4670	5.4752	9.5440	11.0640	-64.7426
2024-09-29 20:57:15.00	2024-09-29 15:57:15.00	272.0091	43.257933	-87.961030	4.7536	213.2919	3.3508	284.5895	0.0450	0.0996	18.0993	19.6702	23.7390	11.0702	-99.8272
2024-09-29 20:57:27.00	2024-09-29 15:57:27.00	284.0091	43.258023	-87.961071	4.7529	211.8722	3.3518	295.1281	1.2950	1.5096	341.8406	349.5578	353.6266	11.0698	-8.8819
2024-09-29 20:57:47.99	2024-09-29 15:57:47.99	305.0091	43.258112	-87.961129	4.7769	211.9774	3.3175	306.0874	0.0619	1.2828	159.8392	355.8141	359.8829	11.0703	135.9313
2024-09-29 20:57:55.99	2024-09-29 15:57:55.99	313.0088	43.258199	-87.961166	4.7535	212.2019	3.3509	316.2141	0.0491	1.2623	159.8392	346.5963	350.6652	11.0790	33.0498
2024-09-29 20:58:04.99	2024-09-29 15:58:04.99	322.0083	43.258286	-87.961236	4.7523	212.4499	3.3526	327.4551	0.1042	1.1661	159.8391	339.0922	343.1610	11.0762	45.3710
2024-09-29 20:58:13.99	2024-09-29 15:58:13.99	331.0084	43.258350	-87.961338	4.7494	212.4297	3.3568	338.3948	0.1514	1.1835	159.8390	291.1885	295.2574	11.0809	98.1708
2024-09-29 20:58:21.99	2024-09-29 15:58:21.99	339.0084	43.258367	-87.961463	4.7471	212.4103	3.3600	348.7096	0.1572	1.3021	159.8390	288.9889	293.0577	11.0860	-366.3437
2024-09-29 20:58:29.99	2024-09-29 15:58:29.99	347.0083	43.258385	-87.961589	4.7456	212.0180	3.3622	359.1240	0.2117	1.3034	159.8389	284.3057	288.3745	11.0788	-51.8214
2024-09-29 20:58:37.99	2024-09-29 15:58:37.99	355.0090	43.258397	-87.961722	4.7442	212.0041	3.3641	369.9556	0.2239	1.3748	159.8388	285.4585	289.5273	11.0850	-49.6301
2024-09-29 20:58:45.99	2024-09-29 15:58:45.99	363.0083	43.258408	-87.961853	4.7439	212.1071	3.3645	380.6723	0.2159	1.3404	159.8387	293.4787	297.5475	11.0871	148.5967
2024-09-29 20:58:53.99	2024-09-29 15:58:53.99	371.0092	43.258422	-87.961985	4.7430	211.9716	3.3657	391.5033	0.2214	1.4170	159.8387	287.8338	291.9026	11.0913	179.5220
2024-09-29 20:59:02.00	2024-09-29 15:59:02.00	379.0131	43.258432	-87.962115	4.7427	211.8680	3.3662	402.0978	0.1960	1.2938	159.8386	289.4905	293.5593	11.0876	-98.9917
2024-09-29 20:59:10.00	2024-09-29 15:59:10.00	387.0094	43.258438	-87.962245	4.7409	212.2787	3.3687	412.7236	0.2459	1.3626	159.8385	288.4855	292.5543	11.0903	178.5049
2024-09-29 20:59:18.00	2024-09-29 15:59:18.00	395.0093	43.258449	-87.962372	4.7395	212.1684	3.3707	423.1382	0.1376	1.2548	159.8384	282.0509	286.1197	11.0948	170.0693
2024-09-29 20:59:26.00	2024-09-29 15:59:26.00	403.0123	43.258456	-87.962506	4.7416	212.4148	3.3677	433.9704	0.2314	1.3571	159.8384	281.9773	286.0461	11.0936	207.4622
2024-09-29 20:59:34.00	2024-09-29 15:59:34.00	411.0093	43.258456	-87.962636	4.7430	212.4689	3.3658	444.5795	0.2229	1.3162	159.8383	266.7874	270.8562	11.1012	60.5688
2024-09-29 20:59:42.00	2024-09-29 15:59:42.00	419.0094	43.258449	-87.962765	4.7429	212.4533	3.3659	455.0712	0.2529	1.3565	159.8382	277.1464	281.2152	11.1017	100.6231
2024-09-29 20:59:50.00	2024-09-29 15:59:50.00	427.0094	43.258444	-87.962901	4.7424	212.0791	3.3666	466.1221	0.3029	1.3496	159.8381	276.3057	280.3745	11.0973	134.2037
2024-09-29 20:59:58.00	2024-09-29 15:59:58.00	435.0093	43.258452	-87.963036	4.7423	212.2661	3.3668	477.0894	0.2048	1.4267	159.8380	296.4828	300.5516	11.1070	-82.0998
2024-09-29 21:00:07.00	2024-09-29 16:00:07.00	444.0087	43.258483	-87.963152	4.7424	212.4509	3.3667	487.2137	0.0872	1.3488	159.8380	285.6549	289.7238	11.1268	65.0812
2024-09-29 21:00:28.00	2024-09-29 16:00:28.00	465.0089	43.258567	-87.963220	4.7516	212.4510	3.3536	498.0240	0.0791	1.3048	140.3463	351.0920	355.1608	11.1010	43.2536
2024-09-29 21:00:36.00	2024-09-29 16:00:36.00	473.0134	43.258658	-87.963274	4.7464	212.5751	3.3610	509.0260	0.1034	1.3249	140.3463	351.6052	355.6740	11.1080	76.0440
2024-09-29 21:00:44.00	2024-09-29 16:00:44.00	481.0094	43.258754	-87.963306	4.7438	212.3664	3.3646	520.0428	0.1322	1.3377	140.3463	358.7843	2.8531	11.1089	-128.1820
2024-09-29 21:00:52.99	2024-09-29 16:00:52.99	490.0095	43.258853	-87.963331	4.7437	212.8324	3.3649	531.1704	0.1295	1.1975	140.3463	6.4029	10.4717	11.1140	114.9534
2024-09-29 21:01:01.00	2024-09-29 16:01:01.00	498.0099	43.258947	-87.963344	4.7417	213.0102	3.3676	541.7088	0.1189	1.3688	140.3463	7.7912	11.8600	11.1082	29.5857
2024-09-29 21:01:09.00	2024-09-29 16:01:09.00	506.0160	43.259040	-87.963345	4.7442	213.1380	3.3641	551.9865	0.1292	1.2969	140.3463	10.9503	15.0191	11.1167	58.0990
2024-09-29 21:01:17.00	2024-09-29 16:01:17.00	514.0126	43.259142	-87.963339	4.7441	213.5976	3.3642	563.3202	1.2928	1.2240	8.7815	9.9019	13.9707	11.1174	28.0241
2024-09-29 21:01:27.00	2024-09-29 16:01:27.00	524.0115	43.259219	-87.963275	4.7317	213.4548	3.3817	573.3366	0.6910	1.1026	36.7223	358.7447	2.8135	11.1193	83.0371
2024-09-29 21:02:19.00	2024-09-29 16:02:19.00	576.0100	43.259267	-87.963383	4.7406	213.5984	3.3691	583.6300	0.2072	0.0973	32.4517	301.4207	305.4896	11.1220	-87.9082
2024-09-29 21:05:12.00	2024-09-29 16:05:12.00	749.0103	43.259311	-87.963500	4.7412	213.5672	3.3683	594.3112	0.1771	0.3181	58.0291	306.9378	311.0067	11.1333	28.1093
2024-09-29 21:07:01.00	2024-09-29 16:07:01.00	858.0103	43.259328	-87.963637	4.7395	214.3411	3.3707	605.6402	0.2686	1.2517	29.4510	227.2984	231.3672	11.1384	-23.3211
2024-09-29 21:08:57.00	2024-09-29 16:08:57.00	974.0138	43.259352	-87.963757	4.7407	214.3103	3.3690	615.6706	0.1553	0.1438	73.1210	302.9661	307.0349	11.1441	-10.9702

Attachment: Spirit Lake - Rotary Park - LoP (9765 : Rotary Park/ Spirit Lake Boardwalk)

2024-09-29 21:09:14.00	2024-09-29 16:09:14.00	991.0138	43.259418	-87.963842	4.7474	214.2333	3.3596	625.7572	0.8955	0.9145	334.8966	302.9661	307.0349	11.1441	-40.7927
2024-09-29 21:10:42.00	2024-09-29 16:10:42.00	1079.0092	43.259477	-87.963935	4.7607	214.6438	3.3407	635.8260	0.0706	0.4352	88.2359	246.8805	250.9493	11.1980	50.5777
2024-09-29 21:13:41.00	2024-09-29 16:13:41.00	1258.0135	43.259549	-87.964019	4.7461	215.3413	3.3614	646.2315	0.3947	0.6609	328.6446	9.5821	13.6510	11.1941	-12.5583
2024-09-29 21:13:58.00	2024-09-29 16:13:58.00	1275.0098	43.259585	-87.964136	4.7395	215.3523	3.3708	656.5711	0.5026	0.7534	325.7243	342.9213	346.9901	11.1830	-34.9829
2024-09-29 21:17:36.00	2024-09-29 16:17:36.00	1493.0095	43.259679	-87.964118	4.7450	216.4054	3.3630	667.0494	1.0605	0.9150	335.2304	328.7722	332.8410	11.0215	-34.8811
2024-09-29 21:17:46.00	2024-09-29 16:17:46.00	1503.0094	43.259771	-87.964148	4.7378	215.8091	3.3731	677.6191	0.9160	1.2193	336.1079	340.1250	344.1938	11.0400	47.7282
2024-09-29 21:17:54.00	2024-09-29 16:17:54.00	1511.0087	43.259858	-87.964189	4.7399	215.7403	3.3702	687.7652	1.1432	1.2653	351.0959	343.5130	347.5818	11.0551	-26.8796
2024-09-29 21:18:03.00	2024-09-29 16:18:03.00	1520.0085	43.259948	-87.964196	4.7408	216.2466	3.3689	697.8447	1.1514	0.9249	356.6321	353.1907	357.2595	11.0625	20.4249
2024-09-29 21:18:13.00	2024-09-29 16:18:13.00	1530.0090	43.260033	-87.964243	4.7368	217.3419	3.3745	707.9610	0.9088	1.1121	339.4910	322.9344	327.0033	11.0883	15.3666
2024-09-29 21:18:22.00	2024-09-29 16:18:22.00	1539.0091	43.260125	-87.964284	4.7432	217.2282	3.3655	718.7167	1.0364	1.4076	337.7588	306.8828	310.9516	11.1082	16.3829
2024-09-29 21:18:34.00	2024-09-29 16:18:34.00	1551.0089	43.260221	-87.964247	4.7495	217.4726	3.3567	729.8017	0.8388	0.9034	33.4677	22.2850	26.3538	11.1311	22.1380
2024-09-29 21:19:00.00	2024-09-29 16:19:00.00	1577.0089	43.260308	-87.964203	4.7517	217.2194	3.3534	740.1150	0.9043	0.4850	14.1934	11.7648	15.8336	11.1672	-15.6022
2024-09-29 21:19:16.00	2024-09-29 16:19:16.00	1593.0082	43.260407	-87.964207	4.7826	217.2718	3.3093	751.1276	1.0280	0.4732	351.1774	2.7208	6.7896	11.1191	135.9991
2024-09-29 21:21:48.00	2024-09-29 16:21:48.00	1745.0132	43.260497	-87.964177	4.7565	217.7906	3.3467	761.4069	0.9462	0.4238	10.8905	77.4499	81.5187	10.8994	-8.7688
2024-09-29 21:23:38.00	2024-09-29 16:23:38.00	1855.0070	43.260580	-87.964246	4.7531	216.1146	3.3515	772.2416	0.6289	1.1793	342.5264	358.2441	2.3129	10.9242	-8.5686
2024-09-29 21:25:45.00	2024-09-29 16:25:45.00	1982.0061	43.260671	-87.964208	4.7458	217.1010	3.3619	782.8192	0.6122	0.9458	20.0907	80.1841	84.2529	10.9696	25.8548
2024-09-29 21:29:00.00	2024-09-29 16:29:00.00	2177.0065	43.260765	-87.964183	4.7995	216.4944	3.2847	793.3991	0.1414	0.4864	220.5933	354.2628	358.3394	10.8226	-20.7028
2024-09-29 21:29:07.00	2024-09-29 16:29:07.00	2184.0064	43.260866	-87.964198	4.7636	216.1238	3.3365	804.7202	1.0338	1.5298	355.8776	324.1540	328.2306	10.8254	-24.6166
2024-09-29 21:29:18.00	2024-09-29 16:29:18.00	2195.0065	43.260968	-87.964236	4.7680	216.7599	3.3302	816.4080	0.9127	0.9725	342.5716	313.5853	317.6619	10.8325	-118.9050
2024-09-29 21:29:26.00	2024-09-29 16:29:26.00	2203.0098	43.261026	-87.964343	4.7582	217.3838	3.3443	827.2525	1.2417	1.1681	289.2589	285.9981	290.0747	10.8377	27.3390
2024-09-29 21:29:57.00	2024-09-29 16:29:57.00	2234.0060	43.261060	-87.964467	4.7401	216.8624	3.3698	837.9827	1.0455	1.3101	309.6810	307.4169	311.4935	10.8642	20.1331
2024-09-29 21:30:05.00	2024-09-29 16:30:05.00	2242.0064	43.261133	-87.964542	4.7404	216.3002	3.3694	848.1719	1.1778	1.3448	321.0500	284.7286	288.8052	10.8753	-18.8733
2024-09-29 21:30:14.00	2024-09-29 16:30:14.00	2251.0067	43.261205	-87.964626	4.7371	216.7560	3.3740	858.6815	1.1927	1.2578	319.8765	286.0522	290.1288	10.8814	-41.2817
2024-09-29 21:30:23.00	2024-09-29 16:30:23.00	2260.0101	43.261259	-87.964742	4.7398	216.7122	3.3702	869.8478	1.2706	1.3051	292.0354	282.3444	286.4210	10.8803	23.8468
2024-09-29 21:30:35.00	2024-09-29 16:30:35.00	2272.0063	43.261329	-87.964821	4.7421	217.0829	3.3670	879.9193	1.3811	1.3192	327.9226	283.3051	287.3817	10.9008	63.8453
2024-09-29 21:30:43.00	2024-09-29 16:30:43.00	2280.0055	43.261407	-87.964912	4.7400	218.1984	3.3700	891.3360	1.7534	1.4673	335.5516	299.1336	303.2102	10.9150	121.3148
2024-09-29 21:30:51.00	2024-09-29 16:30:51.00	2288.0064	43.261470	-87.965002	4.7437	218.8435	3.3648	901.4230	1.3296	1.2920	316.8383	299.0121	303.0887	10.9201	13.3313
2024-09-29 21:30:59.00	2024-09-29 16:30:59.00	2296.0057	43.261532	-87.965104	4.7430	218.6977	3.3658	912.2097	1.4139	1.3643	301.4936	277.7354	281.8120	10.9230	12.6058
2024-09-29 21:31:08.00	2024-09-29 16:31:08.00	2305.0061	43.261571	-87.965229	4.7421	218.8028	3.3671	923.2540	1.2236	1.3051	287.7823	249.3540	253.4306	10.9285	-70.8332
2024-09-29 21:31:16.00	2024-09-29 16:31:16.00	2313.0063	43.261575	-87.965359	4.7535	219.4318	3.3509	933.7775	1.2914	1.3392	281.6899	275.1296	279.2062	10.9363	31.4247
2024-09-29 21:31:24.00	2024-09-29 16:31:24.00	2321.0063	43.261602	-87.965493	4.7481	219.9137	3.3586	945.0617	1.4602	1.4077	279.1510	268.0833	272.1599	10.9439	17.0605
2024-09-29 21:31:32.00	2024-09-29 16:31:32.00	2329.0063	43.261660	-87.965597	4.7387	220.7607	3.3718	955.6994	1.3132	1.4363	314.8507	279.8726	283.9492	10.9466	20.7475
2024-09-29 21:31:40.00	2024-09-29 16:31:40.00	2337.0073	43.261717	-87.965695	4.7361	221.2284	3.3754	965.8627	1.1735	1.3194	310.6634	283.5073	287.5839	10.9512	17.5475
2024-09-29 21:31:49.00	2024-09-29 16:31:49.00	2346.0101	43.261755	-87.965816	4.7341	221.7395	3.3783	976.5099	1.1974	1.2559	278.0322	270.2530	274.3296	10.9473	17.9817
2024-09-29 21:32:23.99	2024-09-29 16:32:23.99	2381.0064	43.261766	-87.965903	4.7510	222.6406	3.3545	976.5099	0.1395	0.0000	284.1917	74.4610	78.5376	10.9554	-6.3314

Attachment: Spirit Lake - Rotary Park - LoP (9765 : Rotary Park/ Spirit Lake Boardwalk)